PHSKC EXAMPLE PLANS - RWL RISER - VERSION 1 - GUIDANCE SECTION 6 (LAST UPDATED 09/06/2024)

NOTE: SOME OF THE INFORMATION PROVIDED HEREIN HAS BEEN DONATED BY OUR INDUSTRY PARTNERS (MACDONALD MILLER, HVE, IMEG (FORMERLY RUSHING CO), HOLADAY-PARKS) IN ORDER TO EXPEDITE THE CREATION OF THESE SAMPLE PLANS. ANY INADVERTENT REFERENCE TO A SPECIFIC PROJECT IS PURELY COINCIDENTAL

TIPS FOR USING EXAMPLE PLANS:

SEARCH THE PDF (CTRL+F) TO FIND A SPECIFIC PLAN REVIEW DESIGN GUIDANCE REFERENCE. 6X

HOVER OVER QUESTION MARK FOR ADDITIONAL INFORMATION. DOUBLE-CLICK TO OPEN FULL TEXT BOX.

NOTE: NOT ALL GUIDANCE ITEMS ARE CURRENTLY REFLECTED ON AVAILABLE EXAMPLE PLANS

CURRENT DESIGN GUIDANCE:
https://cdn.kingcounty.gov/-/media/king-county/depts/dph/documents/health-safety/environmental-health/plumbing-gas-piping/plumbing-design-guidance.pdf

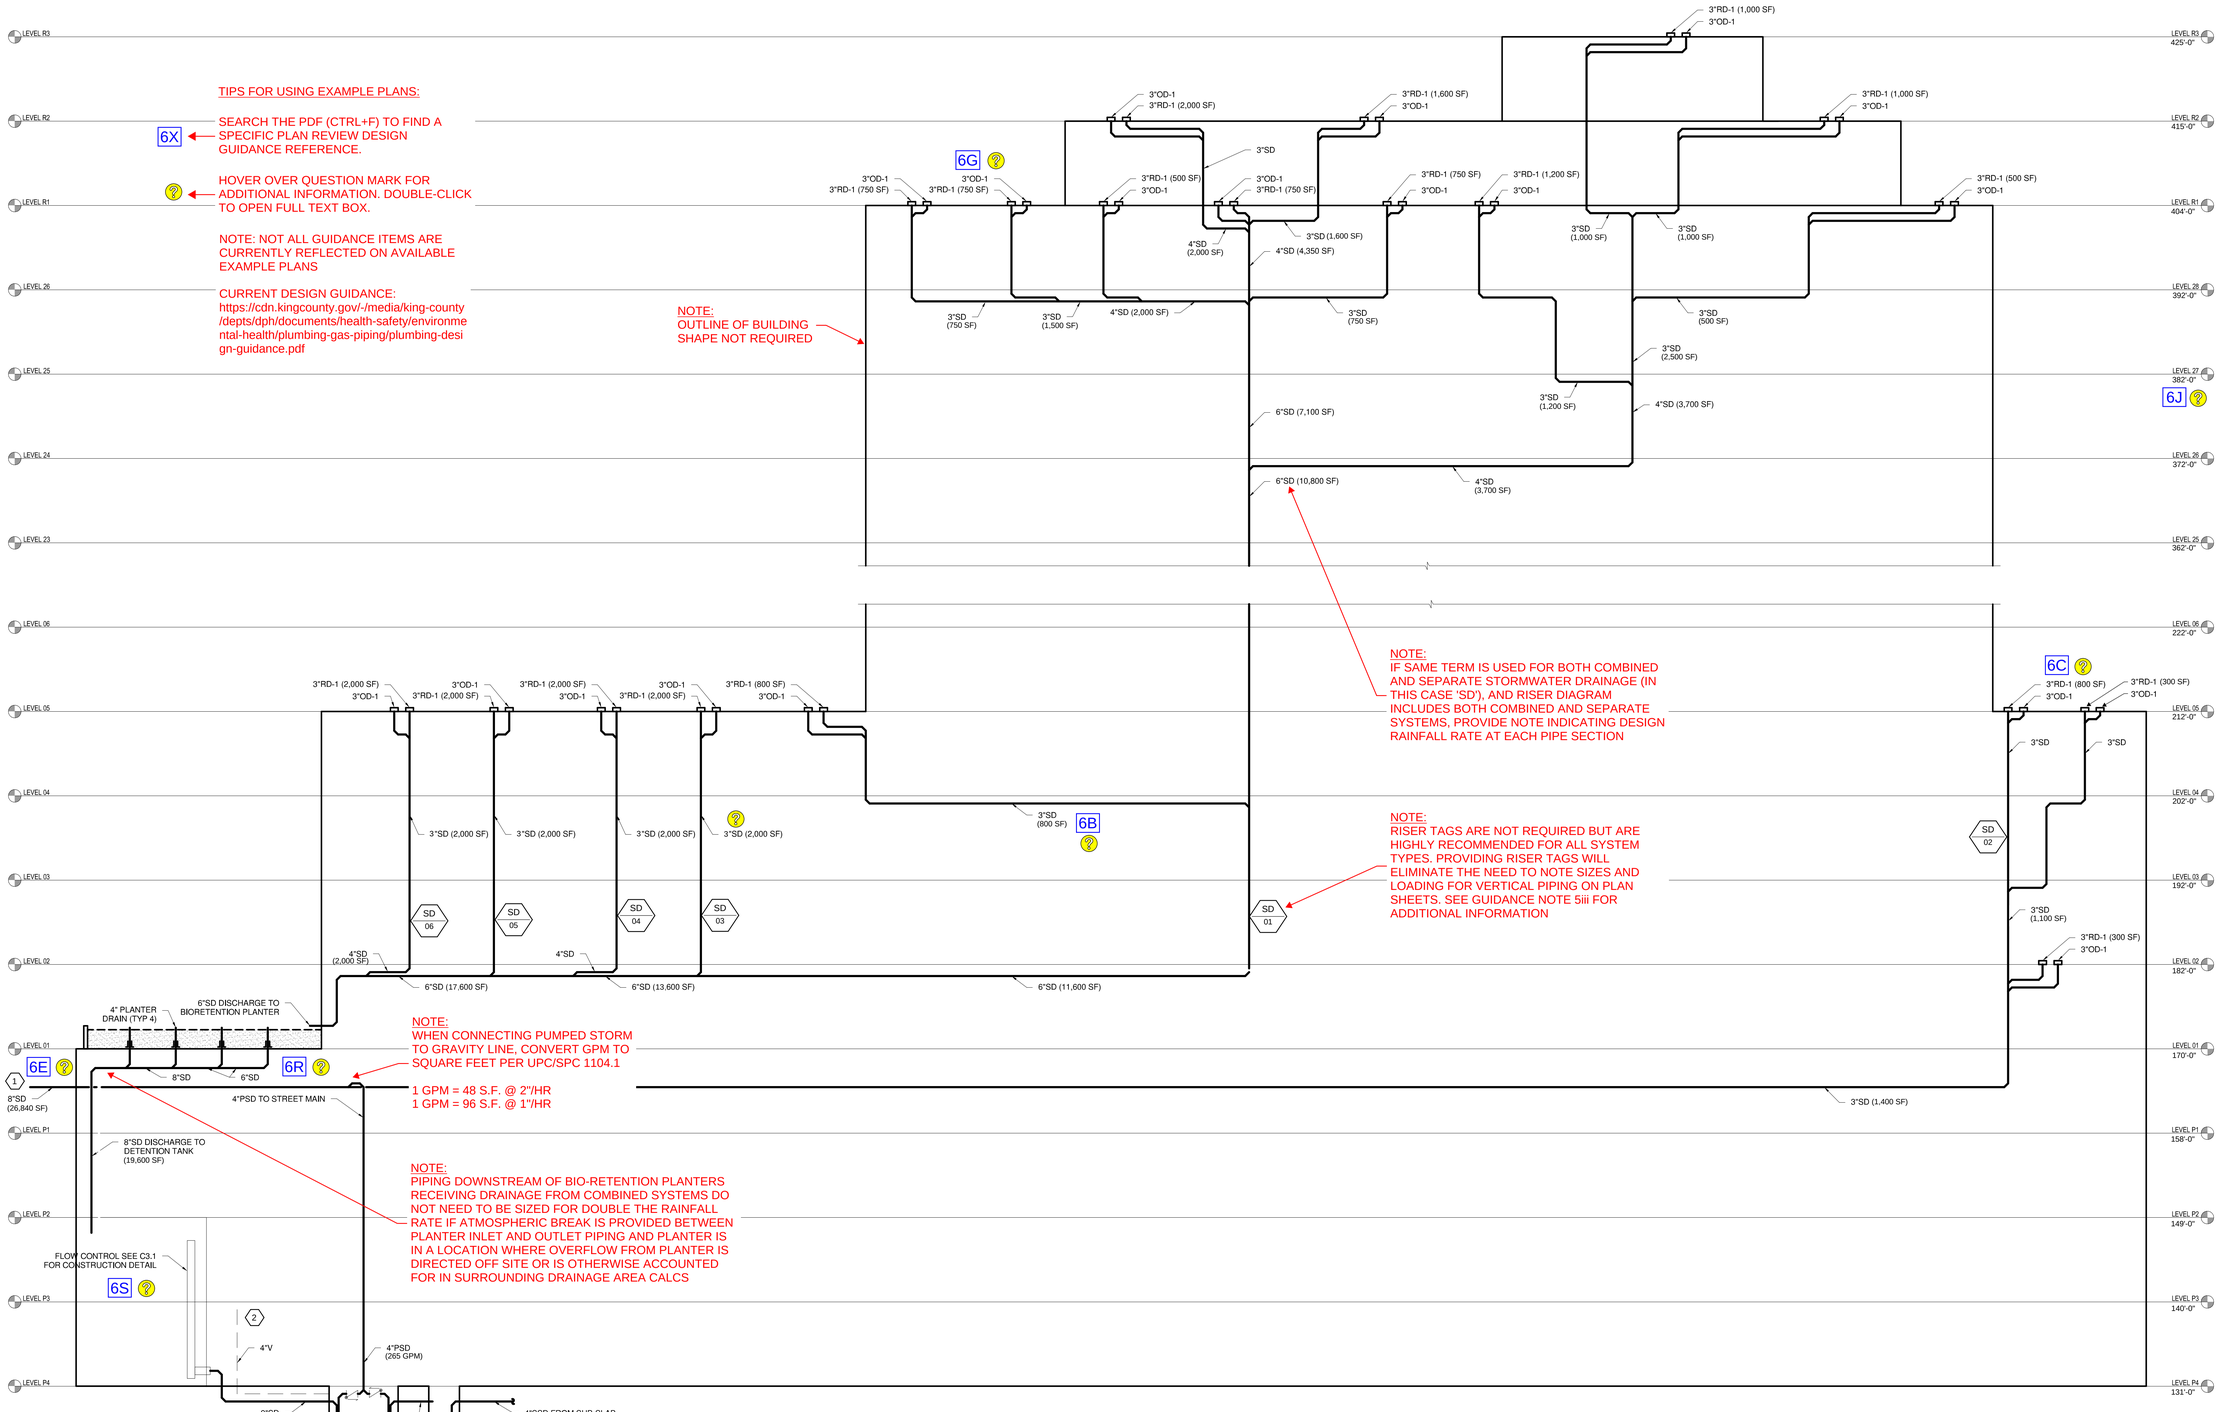

NOTE:
OUTLINE OF BUILDING SHAPE NOT REQUIRED

NOTE:
IF SAME TERM IS USED FOR BOTH COMBINED AND SEPARATE STORMWATER DRAINAGE (IN THIS CASE 'SD'), AND RISER DIAGRAM INCLUDES BOTH COMBINED AND SEPARATE SYSTEMS, PROVIDE NOTE INDICATING DESIGN RAINFALL RATE AT EACH PIPE SECTION

NOTE:
RISER TAGS ARE NOT REQUIRED BUT ARE HIGHLY RECOMMENDED FOR ALL SYSTEM TYPES. PROVIDING RISER TAGS WILL ELIMINATE THE NEED TO NOTE SIZES AND LOADING FOR VERTICAL PIPING ON PLAN SHEETS. SEE GUIDANCE NOTE 5iii FOR ADDITIONAL INFORMATION

NOTE:
WHEN CONNECTING PUMPED STORM TO GRAVITY LINE, CONVERT GPM TO SQUARE FEET PER UPC/SPC 1104.1

1 GPM = 48 S.F. @ 2"/HR
1 GPM = 96 S.F. @ 1"/HR

NOTE:
PIPING DOWNSTREAM OF BIO-RETENTION PLANTERS RECEIVING DRAINAGE FROM COMBINED SYSTEMS DO NOT NEED TO BE SIZED FOR DOUBLE THE RAINFALL RATE IF ATMOSPHERIC BREAK IS PROVIDED BETWEEN PLANTER INLET AND OUTLET PIPING AND PLANTER IS IN A LOCATION WHERE OVERFLOW FROM PLANTER IS DIRECTED OFF SITE OR IS OTHERWISE ACCOUNTED FOR IN SURROUNDING DRAINAGE AREA CALCS

NOTE:
CIVIL SIZING FOR PEAK SITE DRAINAGE MAY BE USED DOWNSTREAM OF FLOW CONTROL STRUCTURE

NOTE:
CONSTRUCTION DETAILS REQUIRED FOR SUMPS AND INTERCEPTORS PER GUIDANCE ITEMS 7B & 7C WHERE APPLICABLE

RAINWATER RISER DIAGRAM

SCALE: NTS

GENERAL NOTES

6ii

1. UNLESS OTHERWISE NOTED, ALL HORIZONTAL PIPING SIZED FOR 1/8" PER FOOT SLOPE.
2. UNLESS OTHERWISE INDICATED, NUMBER IN PARENTHESIS DENOTES SQUARE FOOTAGE OF TRIBUTARY AREA (SF).

6L 6iii

3. SEPARATE PRIMARY AND SECONDARY DRAINAGE PIPING SIZED AT 1"/HR. COMBINED PRIMARY/SECONDARY DRAINAGE SIZED AT 2"/HR.

KEYED NOTES

1. PIPING REQUIRED TO SLOPE AT 1/4" PER FOOT.
2. TERMINATE VENT WITH DOWNTURNED ELBOW (GOOSENECK) MIN. 7' AFF.

NOTE: THESE SAMPLE PLANS ARE NOT INTENDED TO MANDATE A SPECIFIC LAYOUT, FORMAT, OR METHODOLOGY. THESE PLANS ARE PROVIDED ONLY TO INDICATE THE TYPE OF INFORMATION REQUIRED TO ENSURE AN EFFICIENT AND TIMELY PLAN REVIEW

PHSKC STAMP

ARCHITECT

NAME AND LOGO

CONTACT INFORMATION

ENGINEERING FIRM

NAME AND LOGO

CONTACT INFORMATION

ENGINEER OF RECORD

JOHN DOE
STATE OF WASHINGTON
REGISTERED PROFESSIONAL ENGINEER

DATE

EXAMPLE PROJECT
PROJECT ADDRESS
PROJECT CITY, STATE, ZIP

REVISION HISTORY

DATE	REV	ISSUE
DD/MM/YY	X	PERMIT ISSUE

DESIGNED BY:
DRAWN BY:

DRAWING ISSUE

PERMIT ISSUE

ISSUE DATE

SHEET TITLE

RAINWATER RISER DIAGRAM

SCALE: NTS

SHEET NUMBER

P5.21