PHSKC EXAMPLE PLANS - PLAN SHEETS - VERSION 1 - GUIDANCE SECTION 5 (LAST UPDATED 09/06/2024)

NOTE: SOME OF THE INFORMATION PROVIDED HEREIN HAS BEEN DONATED BY OUR INDUSTRY PARTNERS (MACDONALD MILLER, HVE, IMEG (FORMERLY RUSHING CO), HOLADAY-PARKS) IN ORDER TO EXPEDITE THE CREATION OF THESE SAMPLE PLANS. ANY INADVERTENT REFERENCE TO A SPECIFIC PROJECT IS PURELY COINCIDENTAL

TIPS FOR USING EXAMPLE PLANS:

5X ← SEARCH THE PDF (CTRL+F) TO FIND A SPECIFIC PLAN REVIEW DESIGN GUIDANCE REFERENCE.

? ← HOVER OVER QUESTION MARK FOR ADDITIONAL INFORMATION. DOUBLE-CLICK TO OPEN FULL TEXT BOX.

NOTE: NOT ALL GUIDANCE ITEMS ARE CURRENTLY REFLECTED ON AVAILABLE EXAMPLE PLANS

CURRENT DESIGN GUIDANCE:
https://cdn.kingcounty.gov/-/media/king-county/depts/dph/documents/health-safety/environmental-health/plumbing-gas-piping/plumbing-design-guidance.pdf

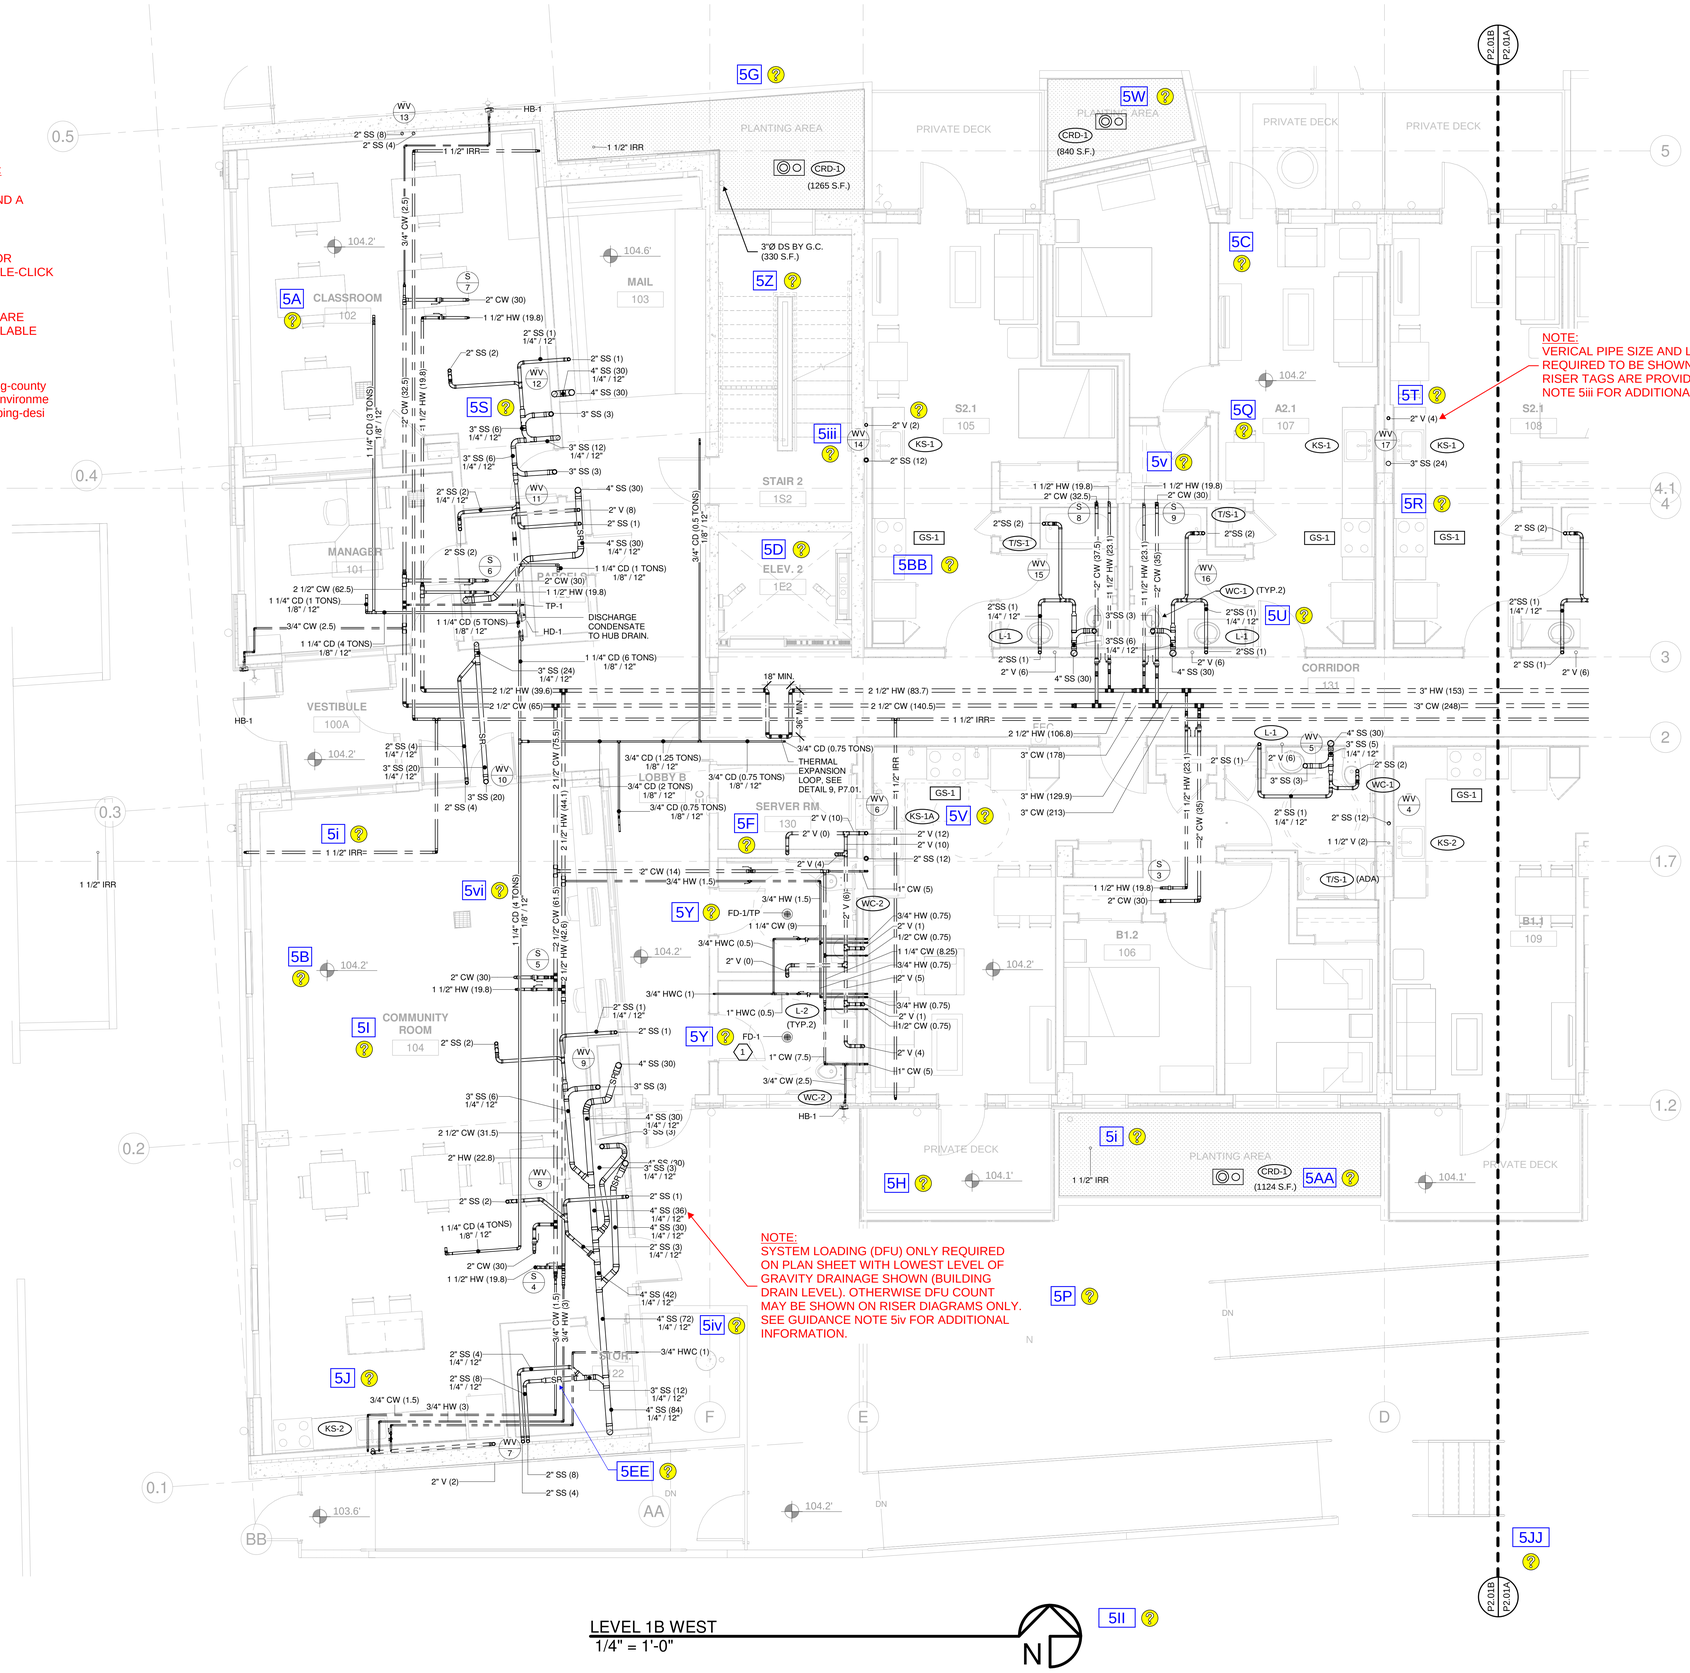

LEVEL 1B WEST
1/4" = 1'-0"

GENERAL NOTES

1. UNLESS OTHERWISE NOTED, ALL WASTE PIPING SHALL SLOPE AT 1/4" PER FOOT.
2. UNLESS OTHERWISE NOTED, ALL STORMWATER PIPING SIZED FOR 1/8" PER FT SLOPE.

KEYED NOTES

1. FLOOR DRAIN SERVED BY TRAP PRIMER.

KEY

0' 2' 4' 8' 16'

NOTE: THESE SAMPLE PLANS ARE NOT INTENDED TO MANDATE A SPECIFIC LAYOUT, FORMAT, OR METHODOLOGY. THESE PLANS ARE PROVIDED ONLY TO INDICATE THE TYPE OF INFORMATION REQUIRED TO ENSURE AN EFFICIENT AND TIMELY PLAN REVIEW

PHSKC STAMP

ARCHITECT

NAME AND LOGO

CONTACT INFORMATION

ENGINEERING FIRM

NAME AND LOGO

CONTACT INFORMATION

ENGINEER OF RECORD

JOHN DOE — STATE OF WASHINGTON — REGISTERED PROFESSIONAL ENGINEER

DATE

EXAMPLE PROJECT
PROJECT ADDRESS
PROJECT CITY, STATE, ZIP

REVISION HISTORY

DATE	REV	ISSUE
DD/MM/YY	X	PERMIT ISSUE

DESIGNED BY:
DRAWN BY:

DRAWING ISSUE

PERMIT ISSUE

ISSUE DATE

SHEET TITLE

LEVEL 1 PLUMBING PLAN - WEST

SCALE: 1/4"/FT

SHEET NUMBER

P2.01B